NOT SHOWN:
BACK UP ALARM
LED TUBE COMPT. LIGHTS
INTERLOCKING TILE COMPT. FLOOR MATTING
DOOR AJAR LIGHT IN CAB
EQUIP RACK UNSTOWED LIGHT IN CAB
100 WATT SIREN

MASTER BATTERY DISCONNECT SWITCH
BATTERY BOOSTING TERMINALS
NON REMOVEABLE KEY
WELDON V-MUX ELEC. SYSTEM
KUSSMAUL BATT. COND. w/ COMPRESSOR
ATTIC LADDER BRACKETS

REV	DESCRIPTION	BY	DATE
4	UPDATED PLUMBING LAYOUT TO AS BUILT	TEC	11-08-18
3	MARKED UP SEPT-12-2018	E SMITH	09-14-18
2	LOWERED PS Side PACK; ADD INT. LIGHTS ON R.RAIL; ADD SLIDING TRAYS REAR COMPT'S	JOL	
1	UPDATE TO SHOP ORDER REVIEW	TEC	08-07-18
A	UPDATE TO NOTES FROM CHANGE ORDER DEC. 14 18	TEC	12-14-18
0	FIRST ISSUE	------	------

REVISIONS

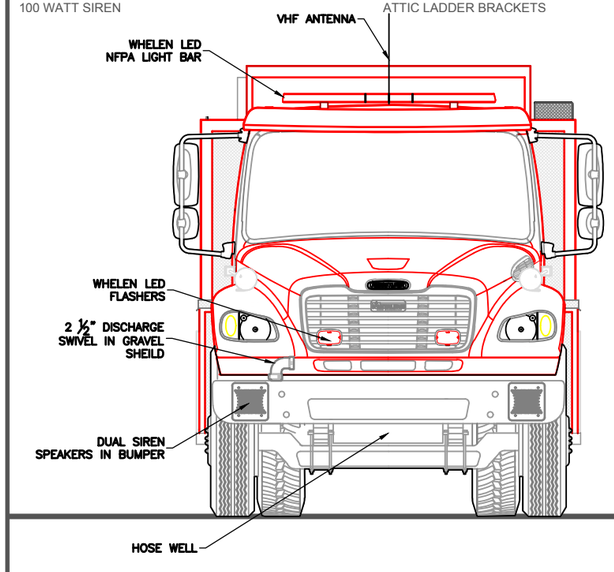

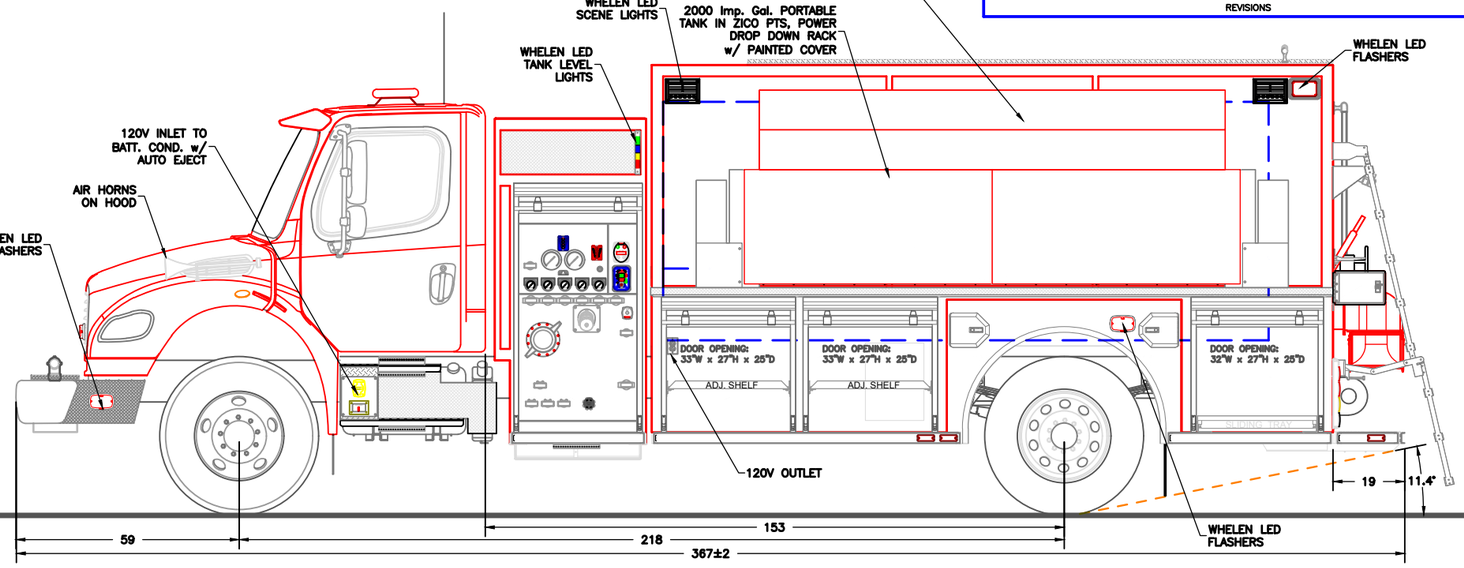

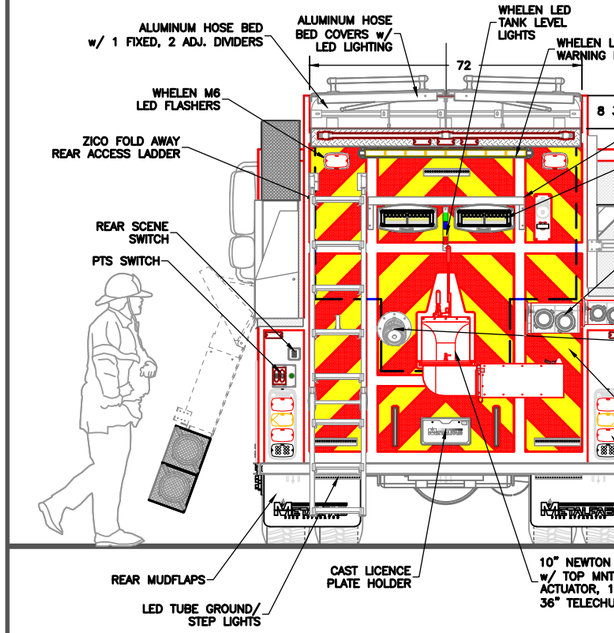

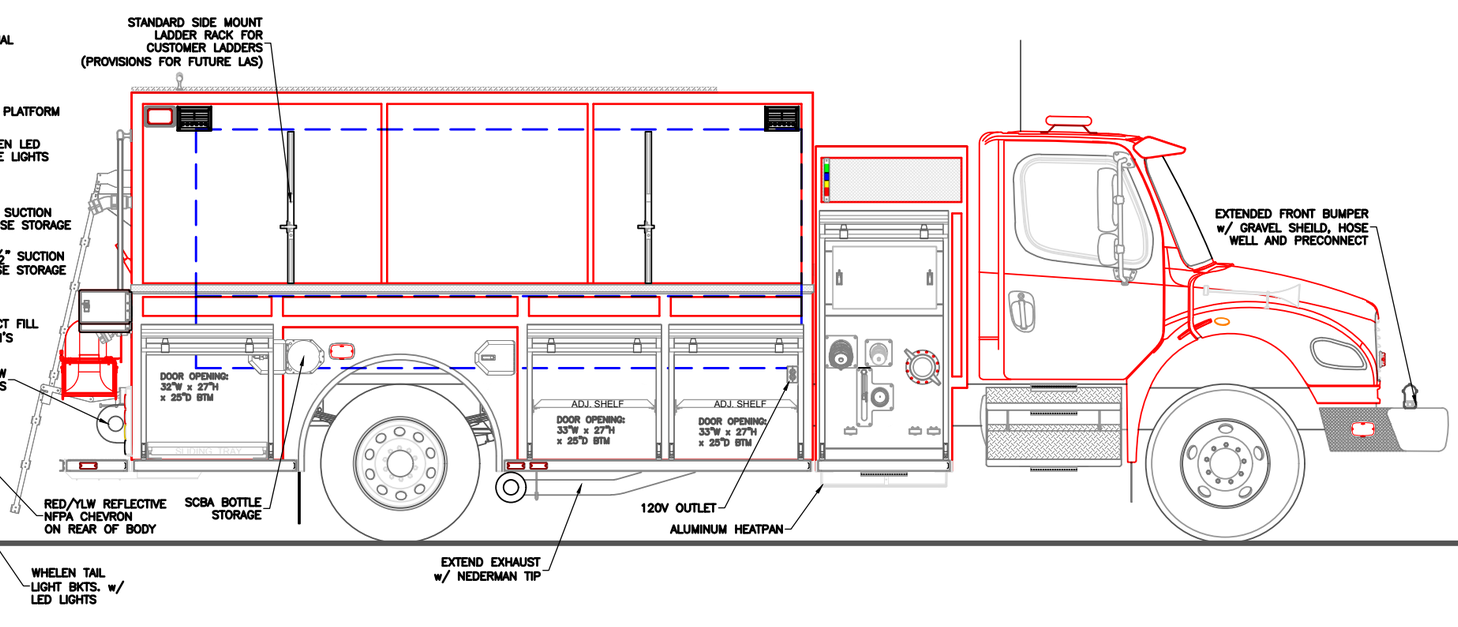

CHASSIS: FREIGHTLINER M2 106 2 DOOR
PUMP: WATEROUS CXVPA 840 IGPM PTO DRIVE
TANK: 1780 Imp. Gal. POLYPROPYLENE
1 – 20 Imp. Gal. FOAM CELL

FOAM: WATEROUS AQUIS 1.5

SUCTION: 1 – 6" LEFT
1 – 6" RIGHT
1 – 3" TANK TO PUMP
1 – 2 1/2" RIGHT

DISCHARGES: 1 – 4" RIGHT
1 – 2 1/2" LEFT
1 – 2 1/2" RIGHT
1 – 2 1/2" REAR
1 – 2 1/2" FRONT
1 – 2" TANK FILL

–ALL ALUMINUM CONSTRUCTION – ALL DIMENSIONS ARE IN INCHES & APPROXIMATE

BROCKTON FIRE DEPARTMENT

JOB No. 20120
DRAWN BY T CULLINS
DATE 07-06-18

METALFAB LTD.
847 CENTRAL ST. CENTREVILLE
NB. CANADA E7K 2E8

TITLE GENERAL ARRANGEMENT

METALFAB FIRE TRUCKS

DRAWING NO. FT-11018
REV 4